

Development Permit Notice of Decision

Date of Decision: November 10, 2025



Proposed Development: Home Based Business Major: Bakery Services
The Sugar Garden

Legal Description: Plan 242 2148, Block 10, Lot 27
Municipal Address: 7001 50A Avenue, Beaumont, AB
Land Use District: Integrated Neighbourhood
Permit Application No: D-2025-99
Tax Roll: 010746

Development Permit Status: Approved with conditions

Development Permit Conditions

The development noted above is considered a Discretionary Use within the Integrated Neighbourhood District and has been **approved** by the Development Authority subject to the conditions listed below. Unless otherwise provided for in this approval, all requirements of the City of Beaumont Land Use Bylaw 944-19 shall be met. **Be sure to review all the documentation included with this permit.**

- 1. As this permit has been issued for a discretionary use, this permit shall not come into full force and effect until the appeal period has expired. See appeal information below.**
2. Development shall commence within one year from the date of decision noted above. If the development does not commence within this time frame, a new development permit will be required.
3. Location of the business operations is approved as shown on the attached site plan.
4. A minimum of one (1) on-site parking stall shall be provided for Client parking, as approved on attached parking plan.
5. A maximum of ten (10) clients per day shall be permitted.
6. One (1) non-illuminated sign, no greater than 0.60m x 0.90m in area, shall be permitted.
7. No more than two (2) employees shall be in attendance on-site at any one time.
8. If the address of the business changes, this permit shall become void and a new permit shall be required to continue operations at a new location.

Development Permit Notice of Decision

Date of Decision: November 10, 2025

Permit Number: D-2025-99

9. Vehicle parking and on/off loading of people shall be controlled by the Applicant/Owner so as not to interfere with the amenities of the neighbourhood. The driveway shall be kept clear of snow to allow for parking.
10. Client appointments shall be staggered to avoid conflicts between arriving and departing clients/vehicles.
11. Hours of operation shall be restricted to Monday - Friday 9:00 a.m. to 5:00 p.m..
12. A current and valid City of Beaumont Business License shall be required each year of operation, or this permit shall become void.
13. The Owner shall ensure that the amenities of the neighbourhood are not negatively affected due to excess noise, traffic, smell, or other conditions which may affect the quality of life of those in the neighbouring areas, as interpreted by the Development Authority.

Additional Information

1. This Notice of Decision is NOT a building permit. Work or construction shall not commence until an applicable Building Permit has been issued under the *National Building Code – Alberta Edition 2023*, and any other applicable bylaws or regulations.
2. This Development Permit is issued under the City of Beaumont *Land Use Bylaw 944-19*. It does not exempt you from compliance with any other municipal bylaw or statutory plan applicable to the Proposed Development, any relevant federal or provincial statute or regulation, or any easement, covenant, agreement, or contract affecting the subject lands.
3. Contact *Alberta One Call* at 1-800-242-3447 to locate underground services prior to construction, if applicable.
4. Electrical, plumbing, and gas permits, as required, shall be the responsibility of the Owner/Applicant. Please, contact regarding permits and inspections for these disciplines.
5. This permit will be circulated to *Beaumont Fire Services*, who will determine if a fire inspection shall be required.
6. This permit is subject to approval or exemption by *Leduc Public Health*. Failure to comply may result in cancellation of this development permit and the associated business license. Contact Leduc Public Health directly at 780-980-4678 to schedule an inspection.

Permit Notification Information

In accordance with the City of Beaumont Land Use Bylaw 944-19, notices regarding this Development Permit have been mailed to owners of adjacent and nearby properties, as these individuals have the right to appeal this permit, as explained above. The same Development Permit Notice mailed to these individuals has been attached for your information.

Development Permit Notice of Decision

Date of Decision: November 10, 2025

Permit Number: D-2025-99

Furthermore, given that this Development Permit is for a development that may be of public interest, general information regarding this approved Permit may be published on the City of Beaumont website.

For more information regarding this Development Permit, its conditions, or the Land Use Bylaw, contact the Development Authority who made the decision on this permit:



Emily Jensen
Development Officer
587-338-5935
emily.jensen@beaumont.ab.ca

Appeal Information

Any Development Permit may be appealed to the Subdivision and Development Appeal Board (SDAB) or the Land and Property Rights Tribunal if the permit was:

- a) issued for a permitted use with a variance, or for a discretionary use, or
- b) issued with conditions, or
- c) refused.

An appeal may be filed by:

- a) the person applying for the permit, and/or
- b) any person affected by the issuance of the permit.

As the person applying for the permit, you may appeal the decision of the Development Authority regarding the permit, or any conditions placed on the permit (as listed above) within 21 days after the date on which the decision is made.


Notice of Decision:	November 10, 2025
Appeal deadline:	December 1, 2025
Permit active (if no appeals filed):	December 2, 2025

To file an appeal or to get information on the appeal process you must contact the Secretary of the SDAB directly at 780-929-8782 or at legislative@beaumont.ab.ca. Appeals must be filed no later than 4:30 p.m. on the date indicated above. Please visit our website for more details at www.beaumont.ab.ca

Permit No.
D-2025-99

Approved November 10, 2025
Development Officer

For Parking Stall and
Location/Use Only

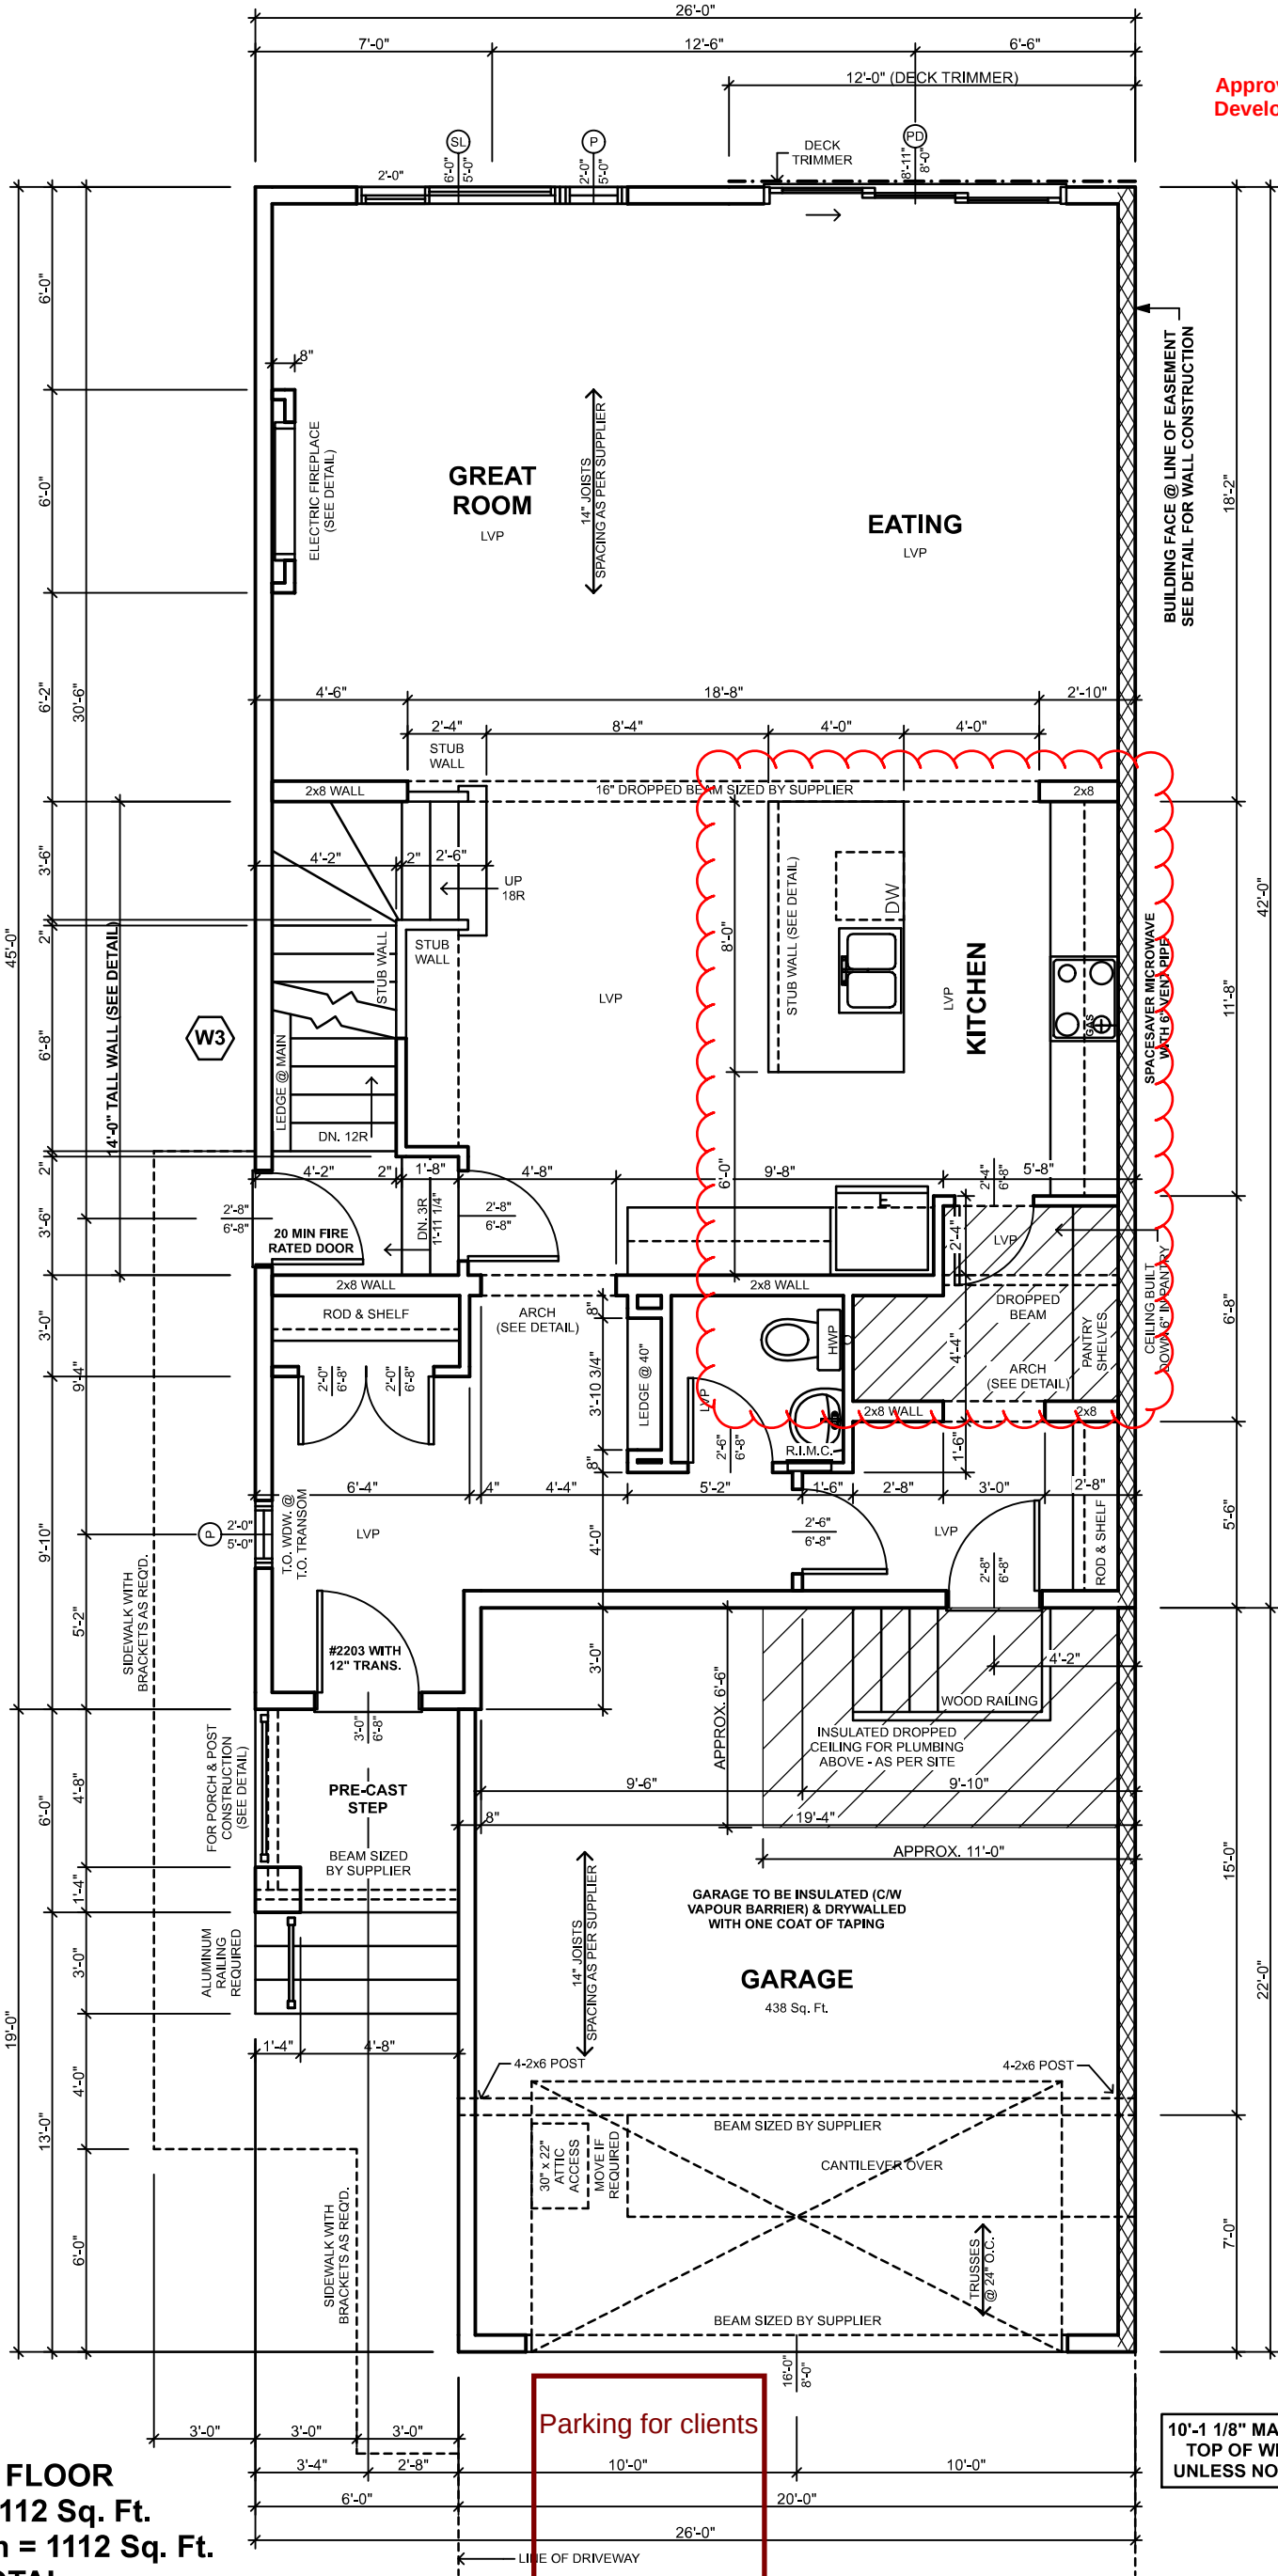

MAIN FLOOR
ABC = 1112 Sq. Ft.
Construction = 1112 Sq. Ft.
TOTAL
ABC = 2557 Sq. Ft.
Construction = 2490 Sq. Ft.

Parking for clients

10'-1 1/8" MAIN FLOOR WALLS
TOP OF WINDOWS @ 9'-0"
UNLESS NOTED OTHERWISE



THESE DRAWINGS AND DESIGN ARE AT ALL TIMES TO REMAIN THE EXCLUSIVE PROPERTY OF "HOMES BY AVI" AND MAY NOT BE REPRODUCED OR USED WITHOUT PRIOR WRITTEN CONSENT.

WRITTEN DIMENSIONS SHALL HAVE PRECEDENCE OVER SCALED DIMENSIONS. IT IS THE RESPONSIBILITY OF THE CONTRACTOR TO NOTIFY THE DESIGNER IN THE EVENT OF DISCREPANCIES. THE CONTRACTOR SHALL CONTACT THE DESIGNER IN ALL MATTERS.

JOB # E4158
Model: Lincoln 26-A32(L2)
Scale: 3/16" = 1'-0"
Design: JH **IDT:** AS

Homes by AVI

PROJECT ADDRESS:
TBD - Elan, Beaumont
Lot 27 Block 10 Plan 242 2148

RELEASE DATES
Plan Check: Nov.6, 2024
Permit:
Construction:

REVISION DATES
Rev #3:
Rev #2:
Rev #1:

4
27